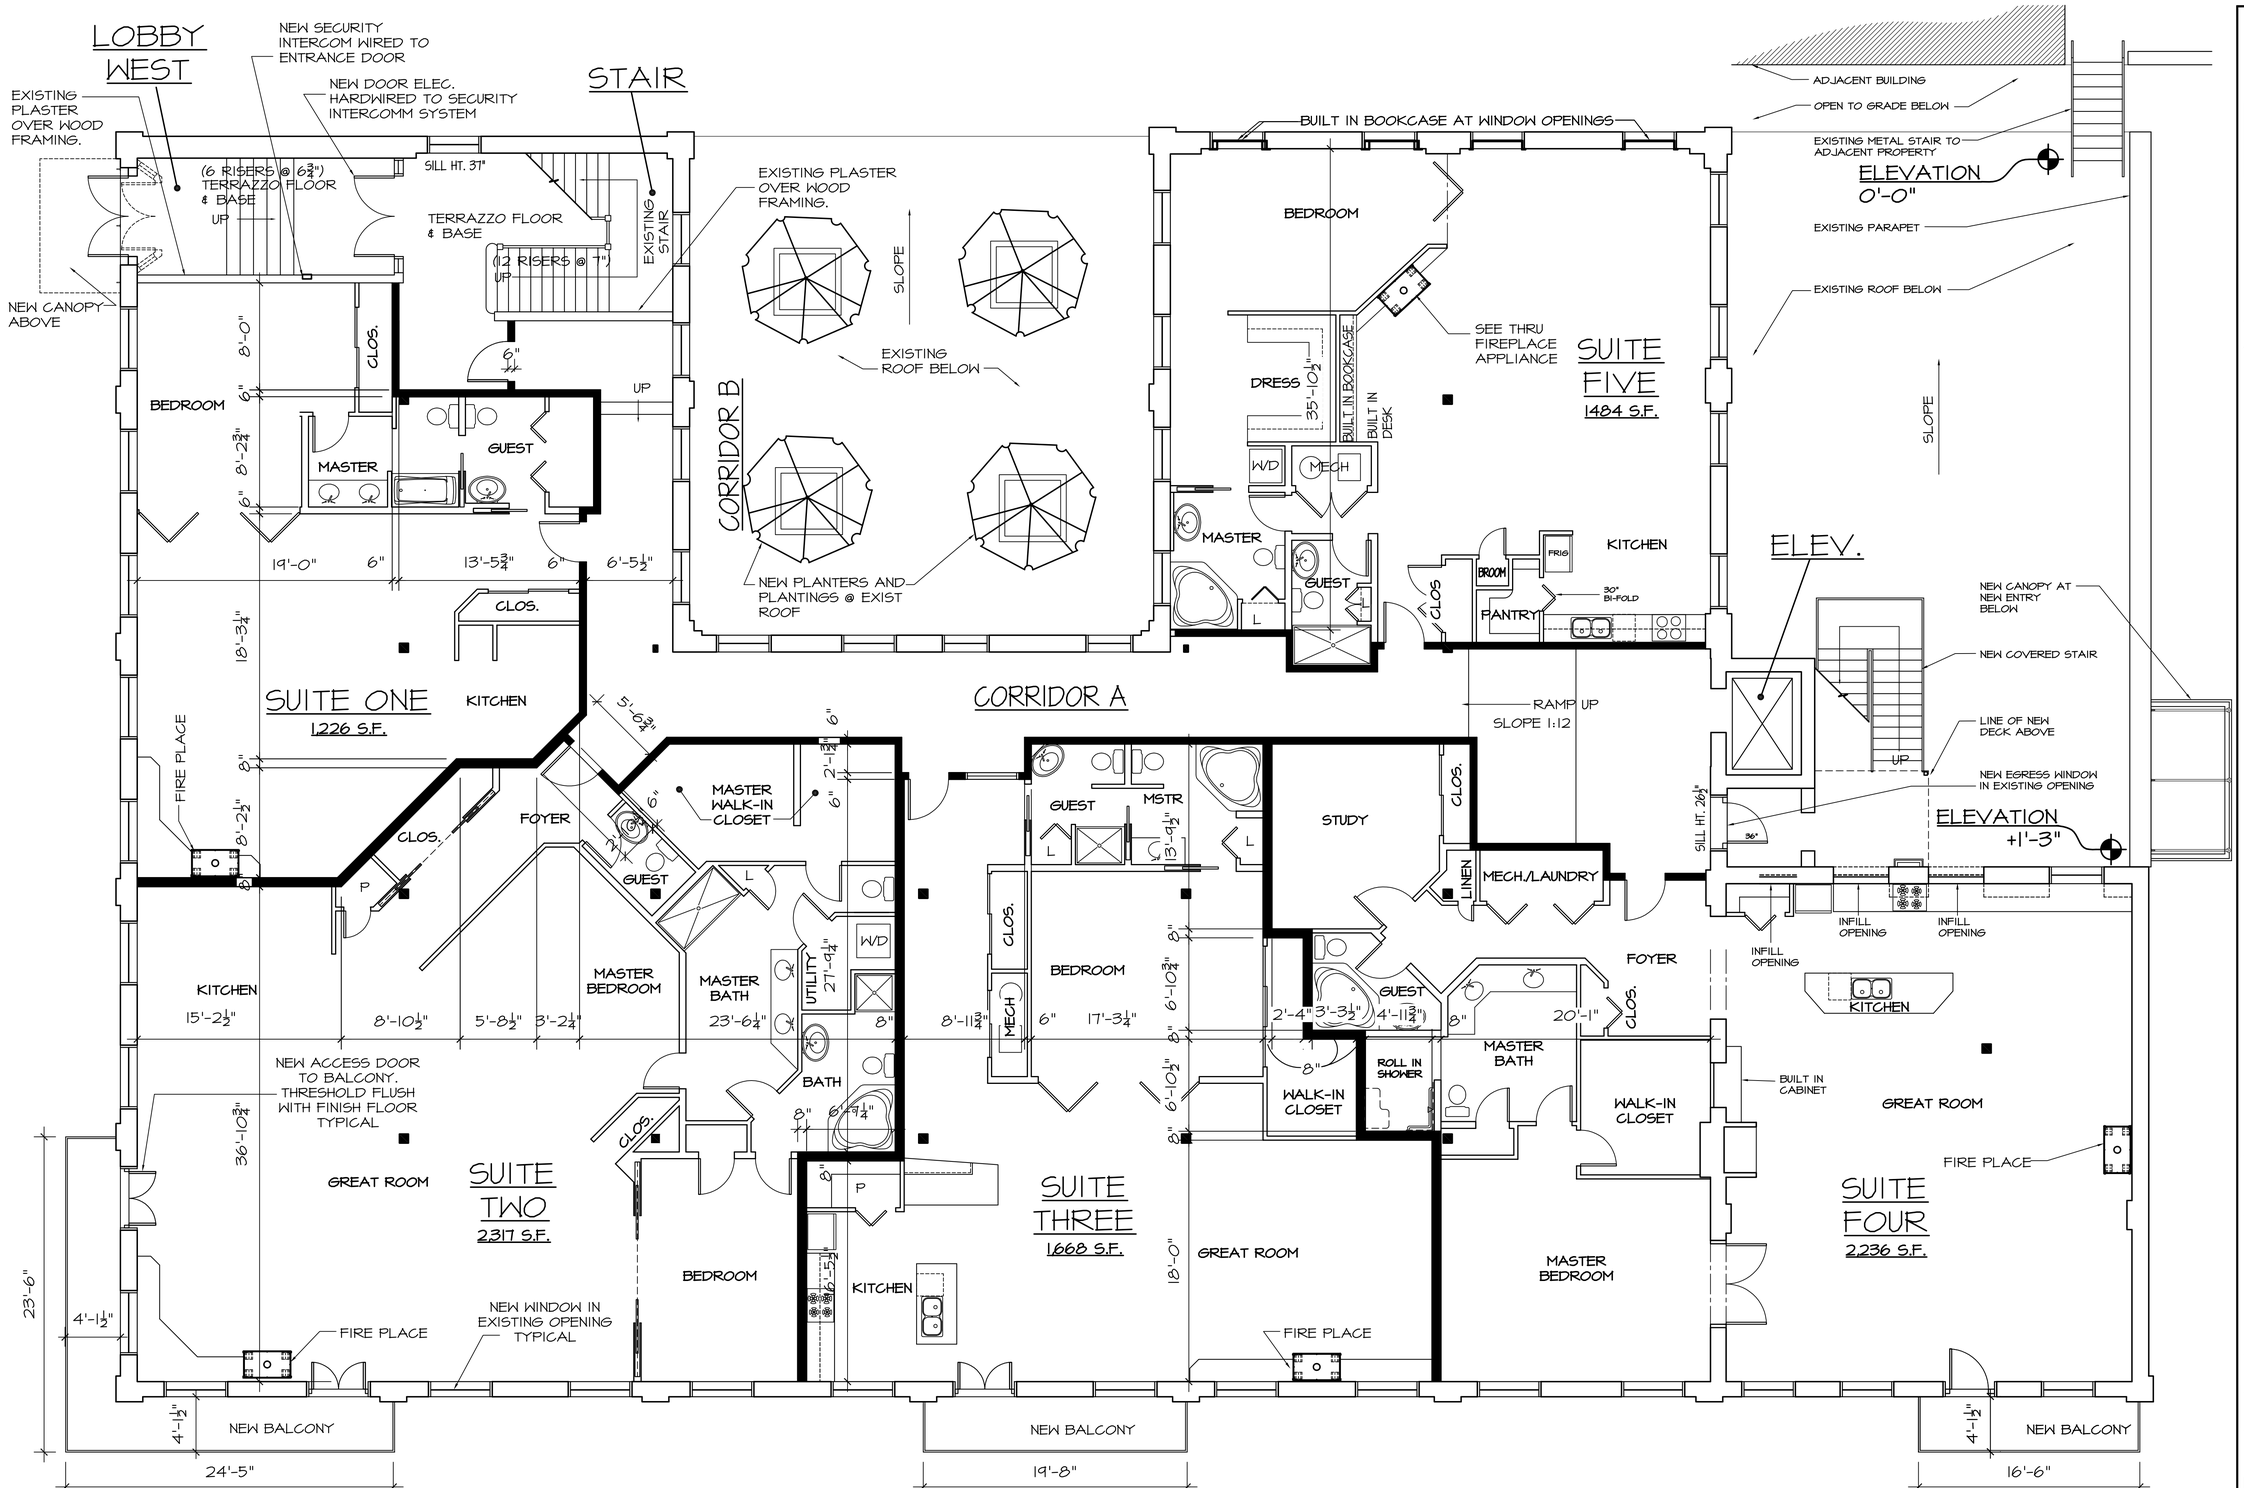

1 FIRST FLOOR PLAN
SCALE: 3/16" = 1'-0"

HENDERSON Associates
ARCHITECTS Inc.
211 E. VANDALIA
EDWARDSVILLE
ILLINOIS
62025
618.656.6618
fax 618.656.3899

REVISIONS
1 JULY 18, 2006 GENERAL REVISIONS

Loft Apartments and Retail Space for
Mississippi Landing
7 Alby Street
Alton, Illinois

TOUR SET
MODIFIED:
PLOTTED: 09.28.06
JOB #: 2623

ISSUE DATE Sept 28, 2006
FILE NAME:
A1 - FIRST FLOOR AS BUILT.DWG
DWN BY: lw
CHK BY: jrh

First Floor Plan
SHEET NO:
A1
OF

HENDERSON ASSOCIATES
Mississippi Landing